


Ore Hill
 Site Survey
 Town of Warren
 Grafton County
 State of New Hampshire



As Built Survey By
 SK & JT
 July 12, 2007

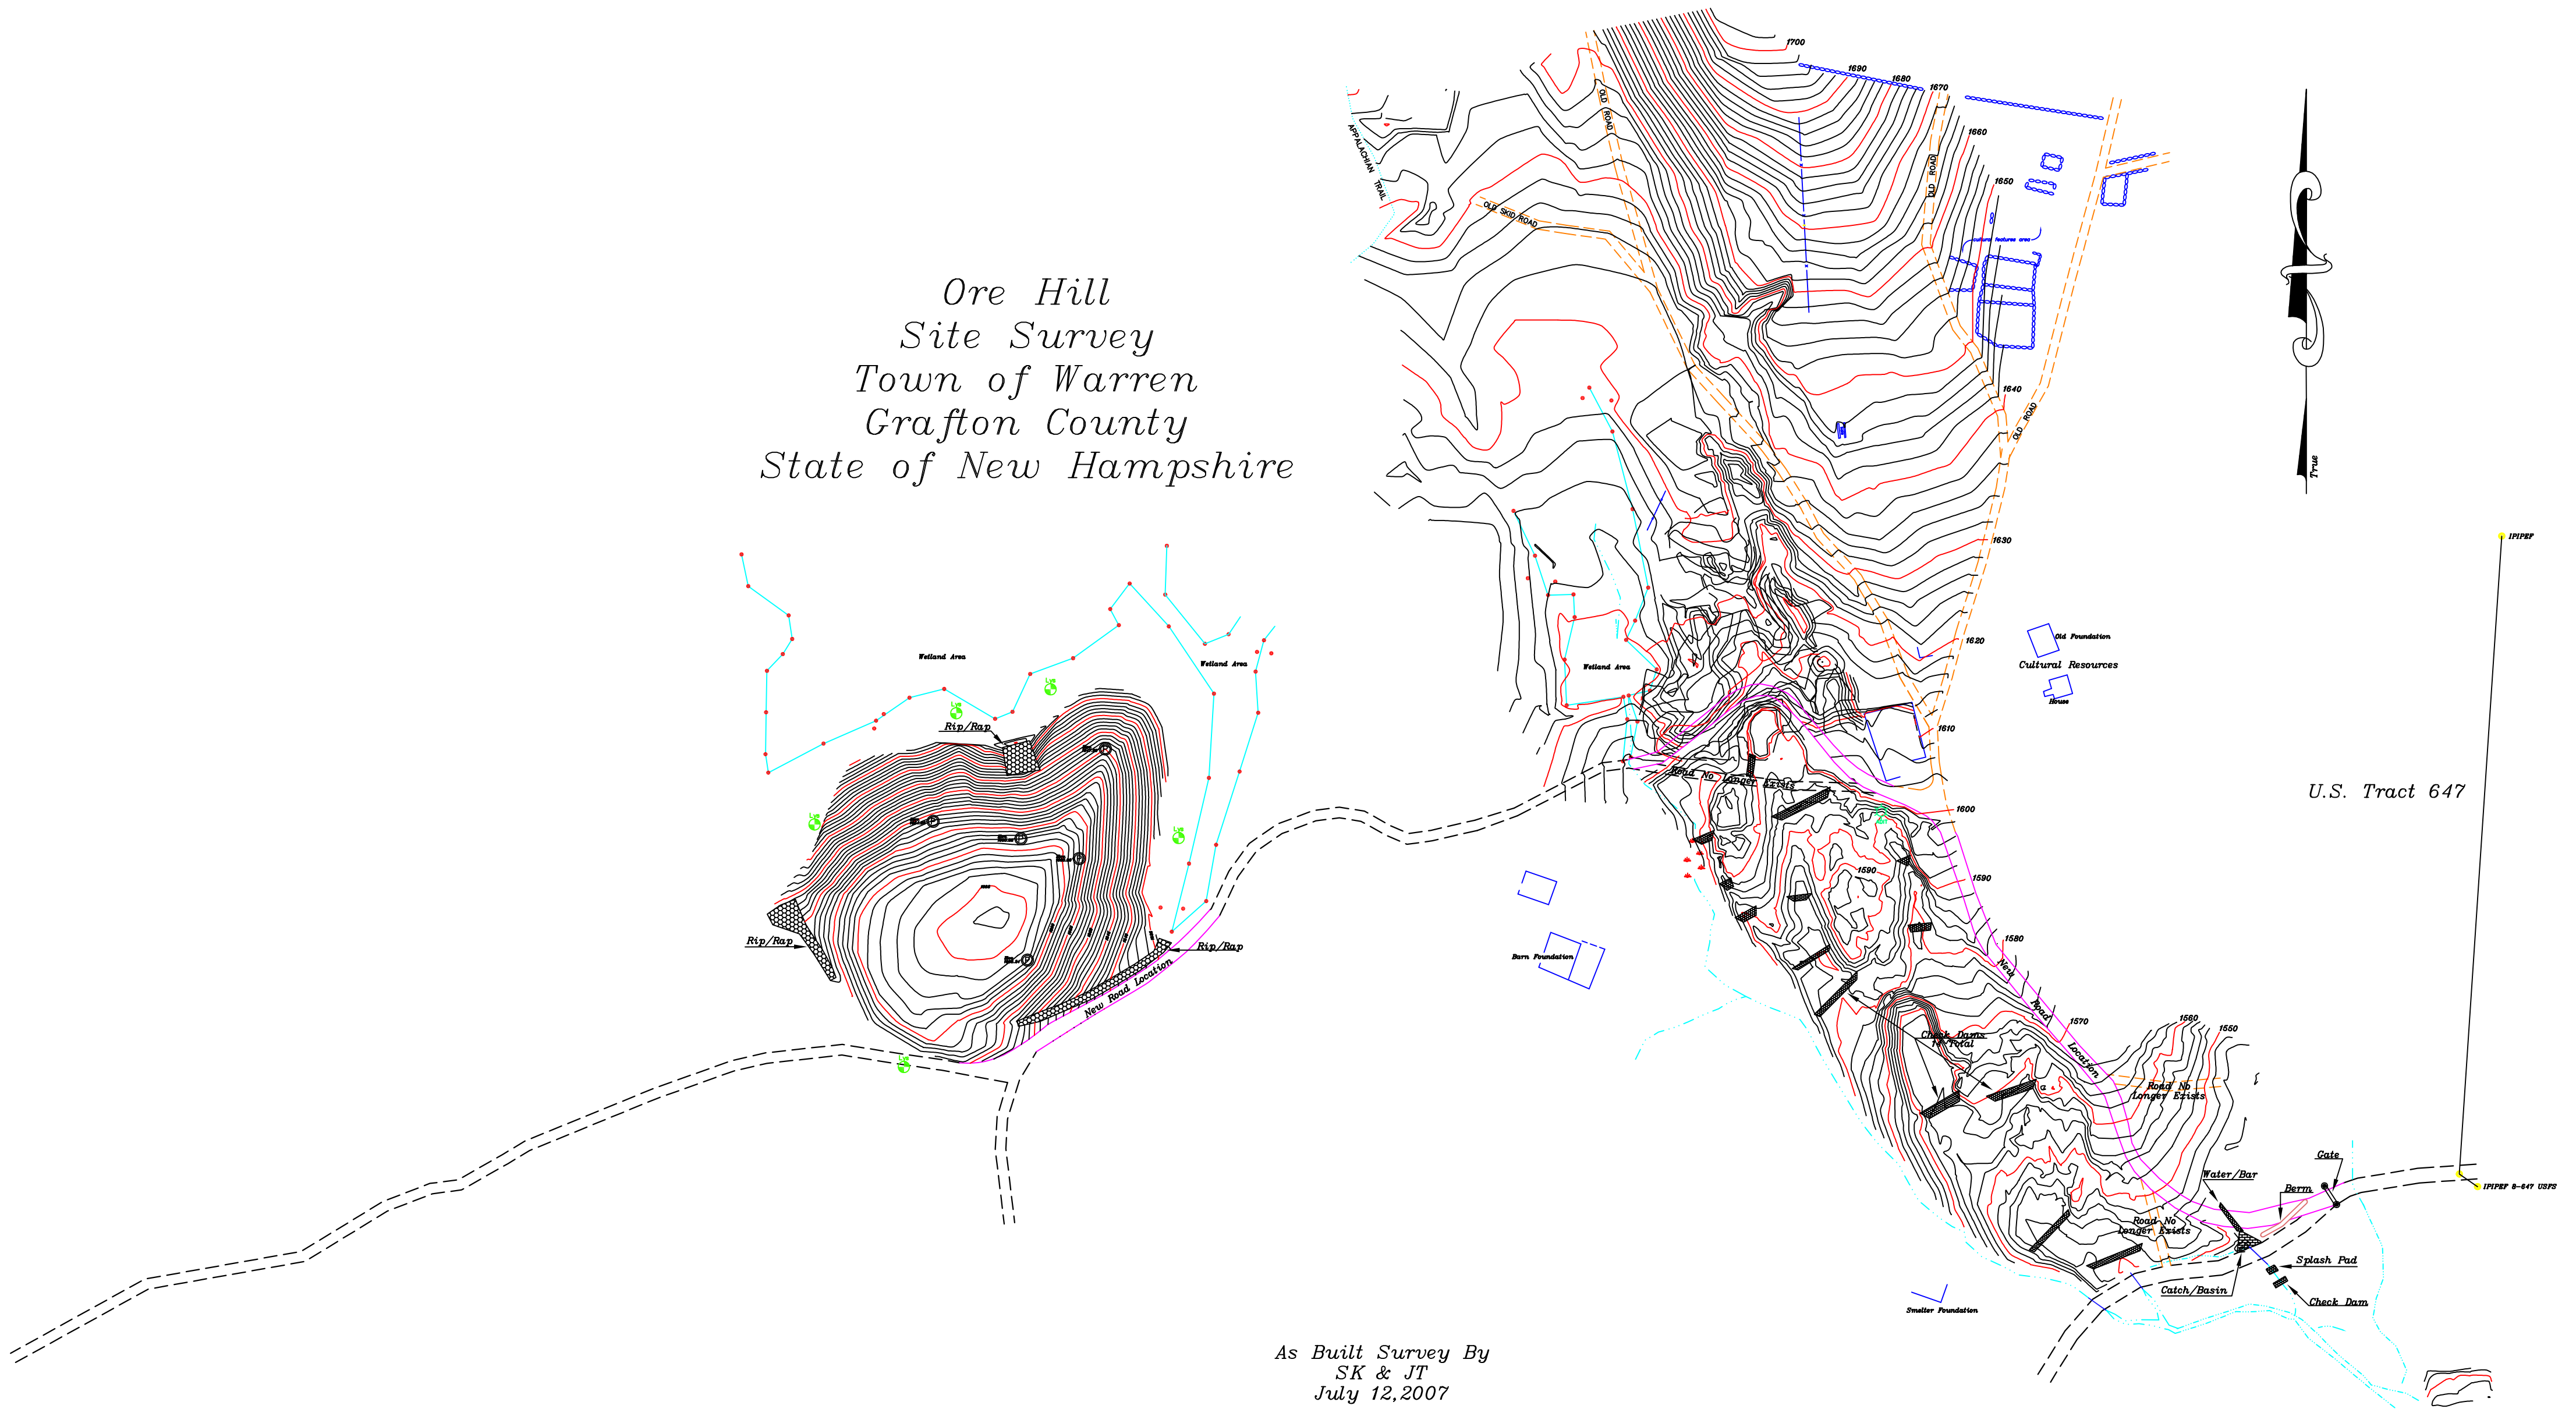