# ORDER NO. 08-04-01-12-360

# UNITED STATES DEPARTMENT OF AGRICULTURE

# CHEROKEE NATIONAL FOREST

## Order for Public Safety

Pursuant to 36 CFR, Section 261.50 (a), it is hereby ordered that the prohibition hereinafter set forth apply to the Spring Creek Shooting Range, Ocoee/Hiwassee Ranger District, within the Cherokee National Forest, shown on the attached map.

1. Possessing a beverage which is defined as an alcoholic beverage by state law with 150 yards of the firing range. **36 CFR 261.58bb**
2. Being in the area after sundown or before sunrise. **36 CFR 261.58l**
3. Entering or using the shooting range or portion thereof on Tuesday's. **36 CFR 261.58b**
4. For public health and safety, weapons may be fired only at stationary targets in front of the designated impact area. **36 CFR 261.53e**
5. For public health and safety, discharging weapons when other shooters are down range is prohibited. **36 CFR 261.53e**
6. For public health and safety, the use of archery equipment is prohibited. **36 CFR 261.53e**
7. For public health and safety, trap, and/or skeet shooting, or firing at any airborne target is prohibited. **36 CFR 261.53e**
8. For public health and safety, discharging a weapon from any location other than the designated firing line, into the designated impact area is prohibited. **36 CFR 261.53e**
9. Riding, hitching, tethering or hobbling a horse or other saddle or pack animal in violation of posted instructions within the designated area. **36 CFR 261.58aa**
10. Failing to adhere to the posted range rules. **36 CFR 261.53e**

**The above-prohibited act is set forth in Title 36 C.F.R. Sections 261.53 and 261.58.**

**Pursuant to 36 CFR, Section 261.50 (e), the following persons or areas are exempt from this Order**:

1. Persons with a special use permit specifically authorizing the otherwise prohibited act or omission, issued by the District Ranger.
2. Any Federal, State, or local officer, or member of an organized rescue or firefighting force in the performance of an official duty.

Executed in Cleveland, Tennessee, this 18 day of May, 2012.

H. Thomas Speaks

H. THOMAS SPEAKS, JR.
Forest Supervisor
Cherokee National Forest

**ORDER EXPIRES FIVE YEARS FROM DATE OF SIGNATURE.**
Violation of these prohibitions set forth above is punishable by a fine of not more than $5,000 for an individual and $10,000 for an organization, or imprisonment for not more than six (6) months, or both. See 16 U.S.C. 551, 18 U.S.C. 3559 and 3571.

ORDER NO 360

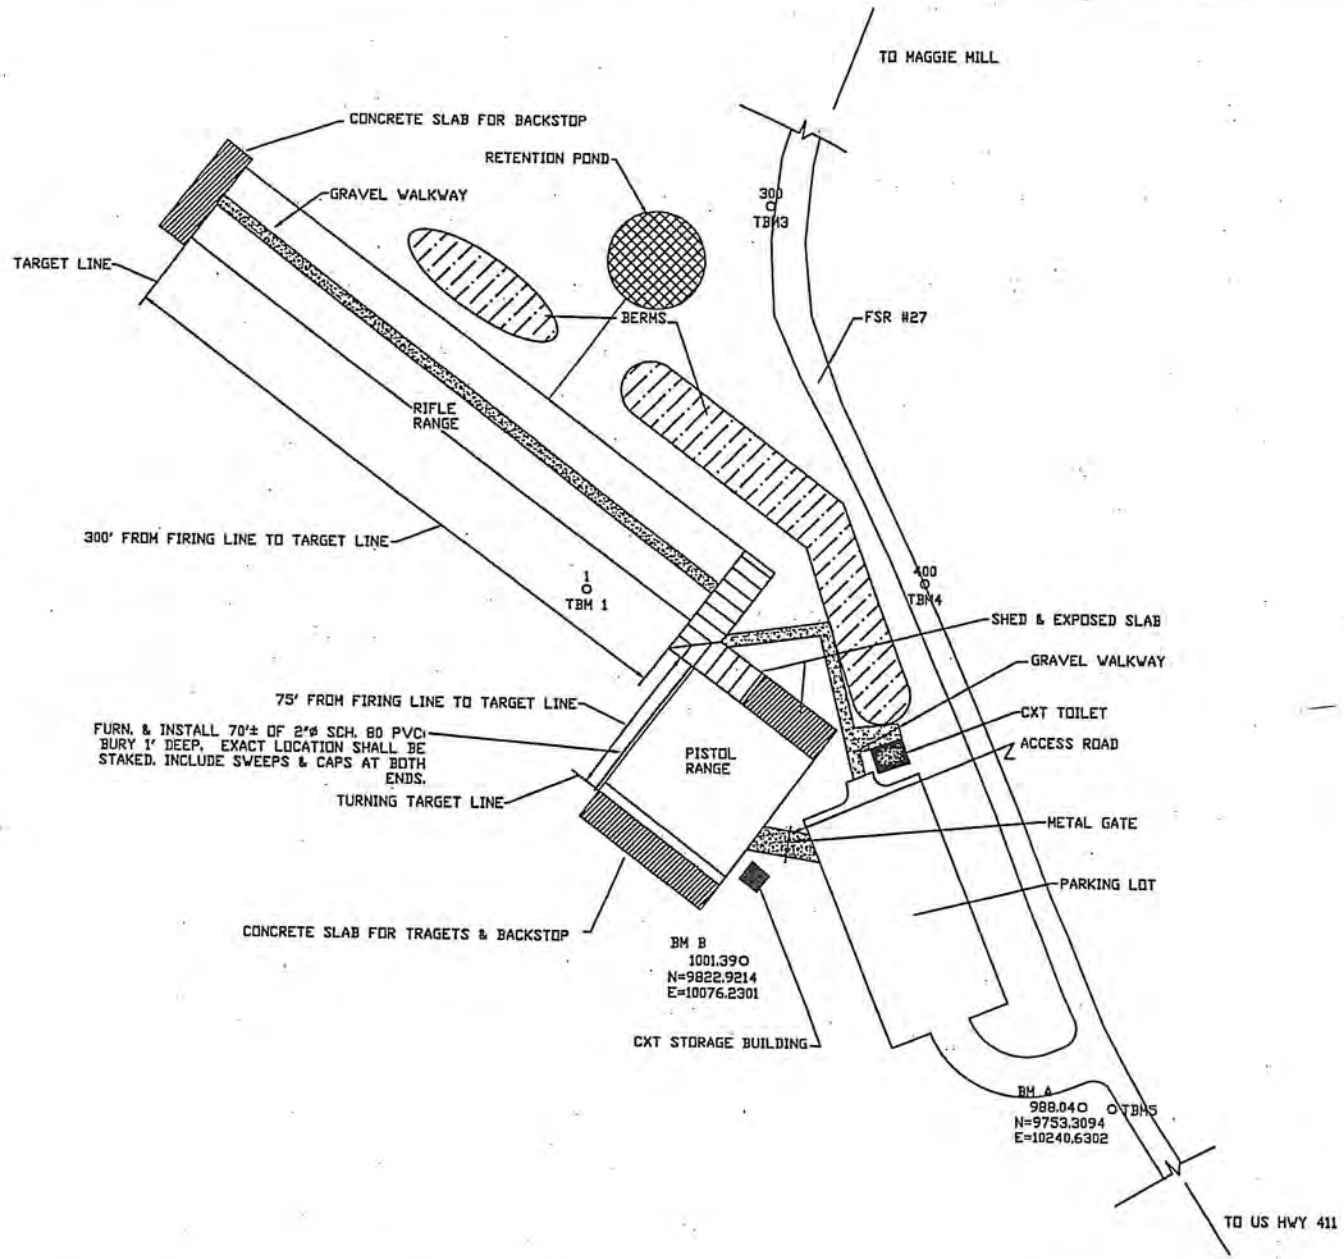


SPRING CREEK SHOOTING RANGE

AS BUILT SITE PLAN

USDA FOREST SERVICE - SOUTHERN REGION (8)

| | | | |
|---|---|---|---|
| REVISED: | DATE: | REV: | DATE: |
| DESIGN: | DATE: | REV: | DATE: |
| CHECK: | DATE: | SCALE: NONE | |
| APPRV: | DATE: | DWG #: NONE | |

SHEET 1